FARMINGTON STATION CONDOMINIUMS

A PART OF SECTION: 19 TOWNSHIP: 3N RANGE: 1E S.L.B.&M.

A PORTION OF LOTS 2,3,4, & 5 PLAT B. FARMINGTON TOWNSITE SURVEY
FARMINGTON CITY, DAVIS COUNTY, UTAH

PREFIX 14
07-203
LAST # 0019

N

SCALE: 1" = 60'

203

07

SEE FARMINGTON STATION CONDO AMD
PG 07-297

LEGEND

- PRIVATE OWNED AREA
- LIMITED COMMON AREA
- COMMON AREA
- PROPOSED MONUMENTS TO BE SET
- REBAR & CAP TO BE SET L.S 141081

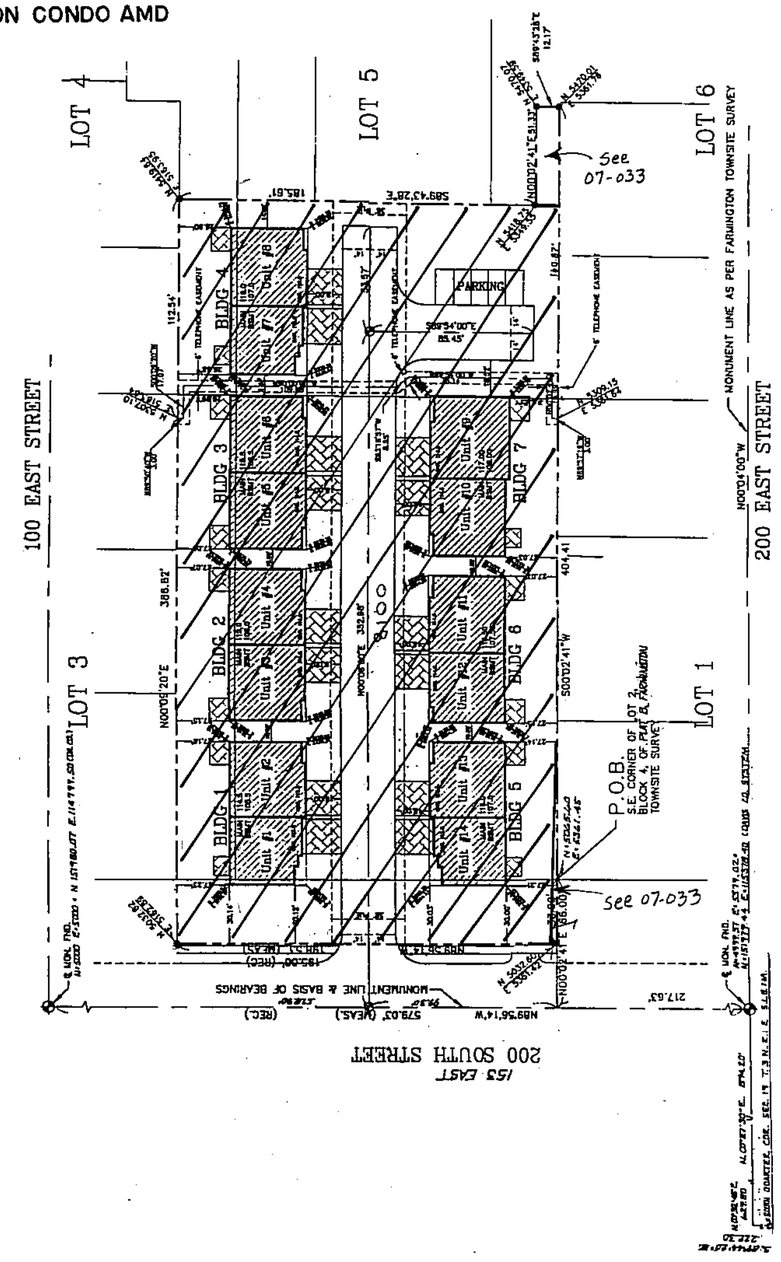

UNITS	BLDG	OWNER	PID
1	1	Jerry B Clayson - TR	0001
2	1	Calvin B Smoot (TRS)	0002
3	2	John Henri Cox	0003
4	2	Connie C. Mansen ETal	0004
5	3	John M. BARGAR TRS	0005
6	3	Terri Shields	0006
7	4	Harry Hankins	0007
8	4	Thomas L. Rich	0008
9	7	DAVID J. [illegible]	0009
10	7	Leslie Hackmaster	0010
11	6	Joan M Arnone	0011
12	6	Robert D Buckwalt	0012
13	5	Earl Nielsen	0013
14	5	Valorie W Calef	0014
~~Common Area~~		~~Farmington Station Owners Assoc. Inc~~	~~0015~~
		-0019 Used - See 07-033	

DEDICATION OF COMMON AREAS

All common areas are hereby dedicated by the owners hereof as utility easement to Farmington City for perpetual use in the installation, operation, and maintenance of any and all utilities necessary to serve this area or adjoining areas.

Byrd & Associates L.C.
Engineers & Land Surveyors
1610 South Main, Suite H
Bountiful, Utah 84010
Phone (801)-292-0400
Fax (801)-292-8216

SUBDIVISION: FARMINGTON STATION CONDOMINIUMS
BLDG 1 - 7
UNITS 1 - 14
UNITS: & COMMON AREA

CITY: FARMINGTON

PART OF SEC.19 T3N R1E
SALT LAKE MERIDIAN
DAVIS COUNTY, UTAH

R 5*29*98